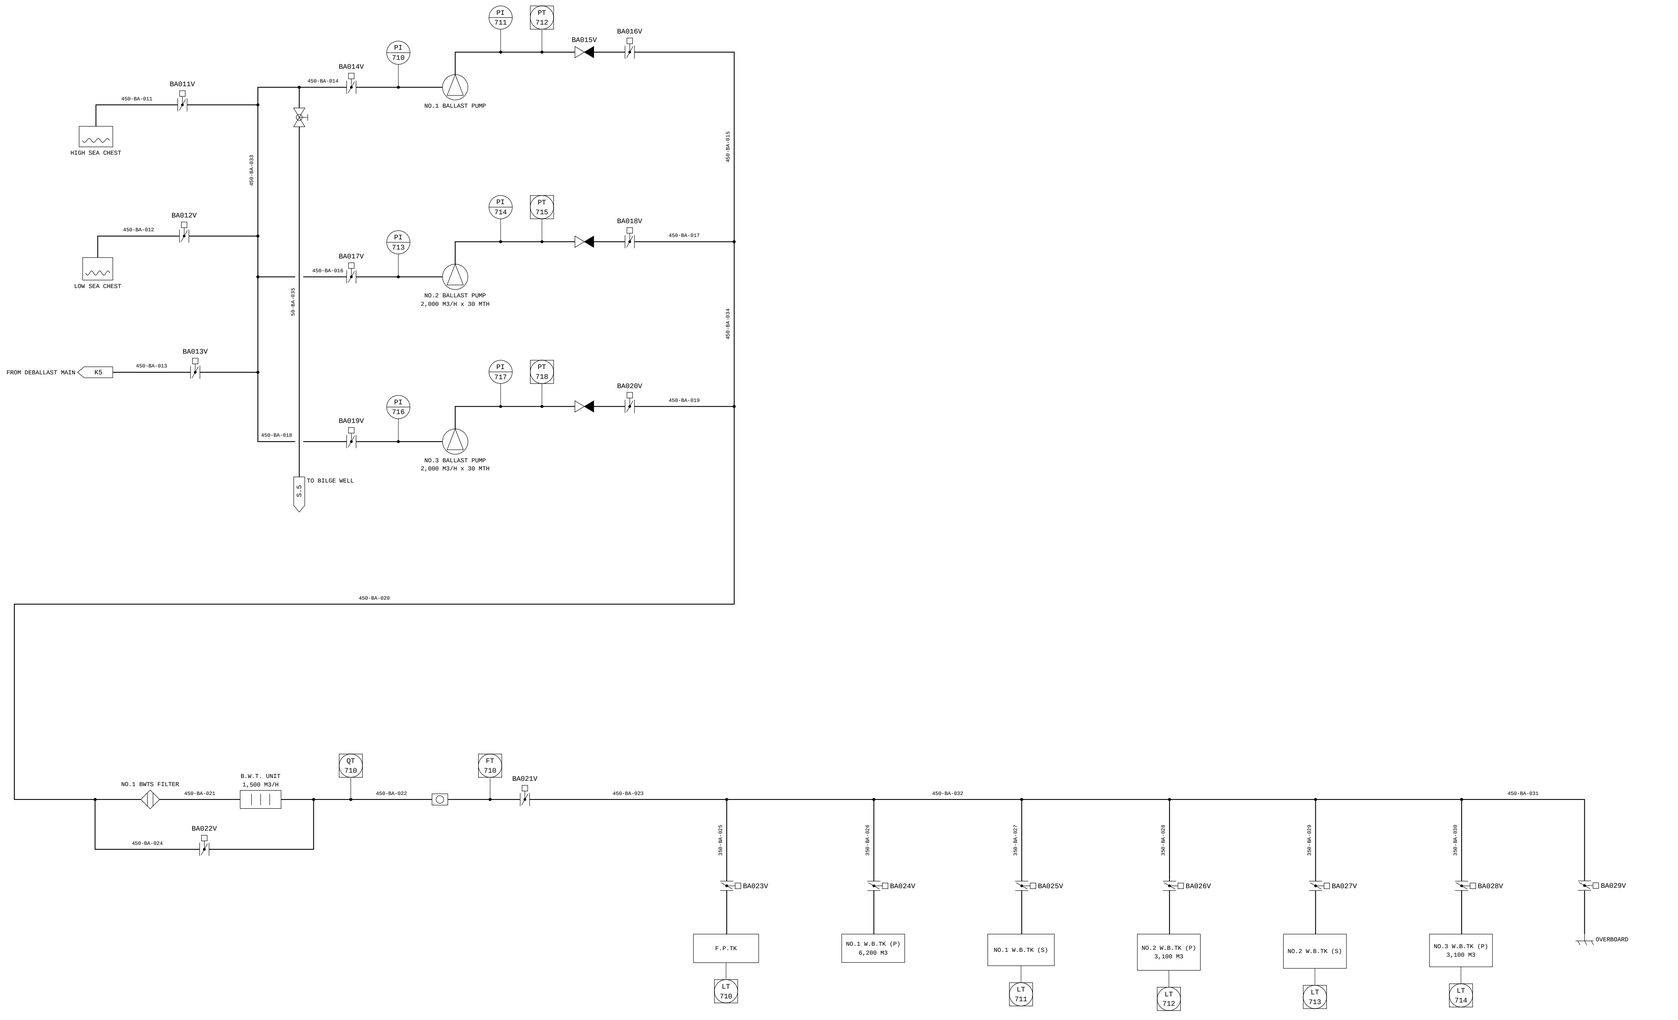

GENERAL NOTES

1. LINE NUMBER DESIGNATION: SIZE - SYSTEM CODE - SERIAL NO. - PIPE CLASS.
2. DIMENSIONS AND ELEVATIONS SEE PIPING ARRANGEMENT DRAWINGS.
3. BALLAST WATER TREATMENT SYSTEM TO COMPLY WITH IMO BWM CONVENTION REG. D-2.

REV.	DATE	DESCRIPTION	DWN	CHK	APP
0	2026-01-15	ISSUED FOR APPROVAL	LIM	CHOI	KIM
1	2026-02-16	ISSUED FOR OWNER'S COMMENT	LIM	CHOI	KIM
2	2026-08-26	FINAL (AS BUILT)	LIM	CHOI	KIM
3	2026-11-24	REVISED AS PER OWNER'S COMMENT	LIM	CHOI	KIM

DRAWN	CHECKED	APPROVED	DATE
K.W. LIM	D.K. CHOI	J.H. KIM	2026-11-24

HALCYON OFFSHORE & SHIPBUILDING

OWNER : POLARIS MARITIME CORP.

HULL NO.	SHIP TYPE
H.7694	24,000 TEU CONTAINER CARRIER

TITLE

BALLAST WATER SYSTEM
DIAGRAMMATIC PIPING

SCALE	SHEET	SIZE	SYSTEM CODE
NONE	1 OF 1	A1	BA

DWG. NO.	REV.
57694-BA447	3